

1 GARAGE FIRST LEVEL - ELEVATOR PLAN
SCALE: 1/8"=1'-0"

LEGEND:

	FIRE ALARM CONTROL PANEL		WALL MOUNTED SPEAKER, M.H. 80" AFF
	FIRE PUMP RUN		WALL MOUNTED SPEAKER/ STROBE, M.H. 80" AFF
	FIRE PUMP FAULT		CEILING MOUNTED SPEAKER
	FIRE PUMP OFF		WALL MOUNTED STORBE, M.H. 80" AFF
	FIRE PUMP RUN ALT POWER SOURCE		CEILING MOUNTED SPEAKER AND STROBE
	FIRE ALARM INTERFACE MODULES		CEILING MOUNTED STROBE
	GENERATOR RUN		SMOKE DETECTOR
	GENERATOR FAULT		DUCT SMOKE DETETOR
	TURNSTILES		HEAT DETECTOR
	PRIMARY RECALL		VALVE TAMPER SWITCH
	ALTERNATIVE RECALL		FLOW SWITCH
	FIREMANS HAT		ALARM PRESSURE SWITCH
	RELAY MODULE		HIGH / LOW PRESSURE SWITCH
	SHUNT TRIP		FIELD PHOTOGRAPH
	MANUAL PULL STATION		

CLIENT INFORMATION



SUPERIOR COURT OF THE
DISTRICT OF COLUMBIA

PROJECT TITLE

FIRE ALARM RISER & FLOOR PLANS
AS-BUILTS

PROJECT LOCATION

SOUTH-WEST PARKING GARAGE

SEAL & SIGNATURE

PROFESSIONAL CERTIFICATION:
I HEREBY CERTIFY THAT THESE DOCUMENTS WERE
PREPARED OR APPROVED BY ME, AND THAT I AM A DULY
LICENSED PROFESSIONAL ENGINEER UNDER THE LAWS OF
THE STATE OF MARYLAND, LICENSE NO. _____
EXPIRATION DATE: _____



ASTUTE ENGINEERING, PLLC.
1945 OLD GALLOW'S ROAD, STE 201, VIENNA, VA 22182
PH: (202) 400-2004 | WWW.ASTUTENG.COM

FOR REVIEW ONLY

REVISIONS		
NO.	DESCRIPTION	DATE


TITLE
GARAGE FIRST LEVEL
FIRE ALARM SYSTEM
AS-BUILT

DRAWING NO.
FA100

SCALE: 1/8"=1'-0"

DATE: 12/04/2023

DES: KS DRAWN: NS CHECKED: HU

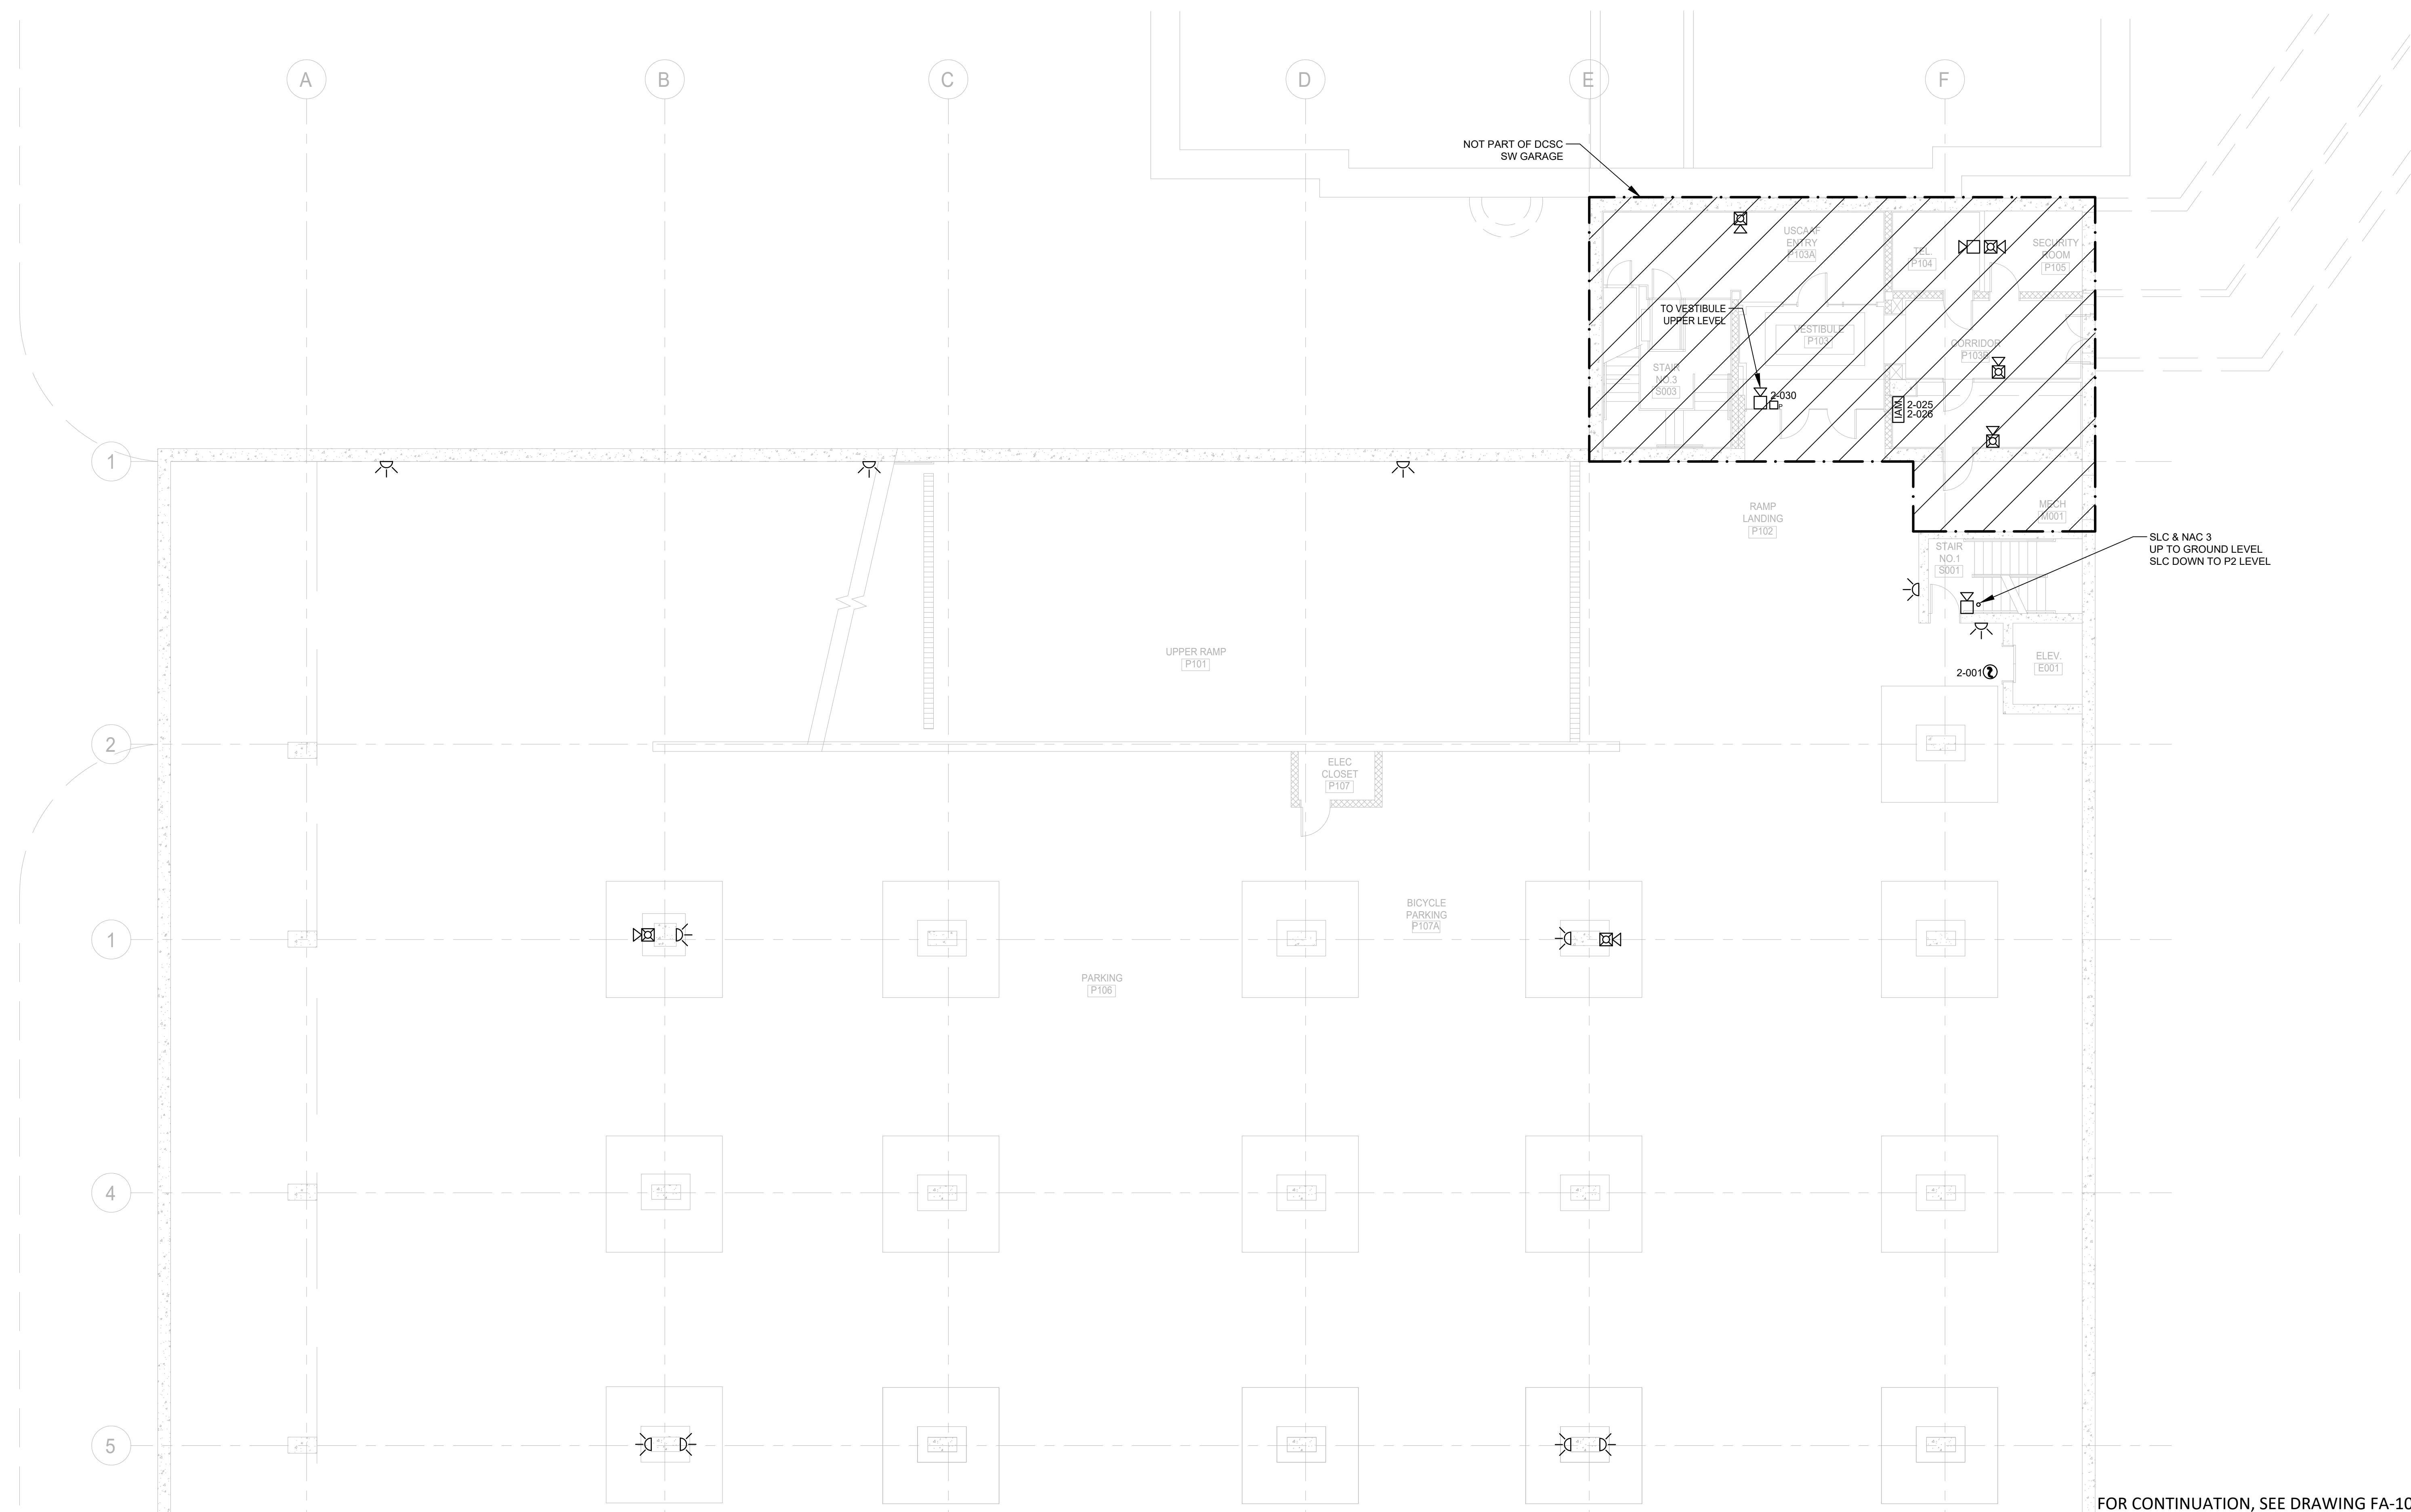

1 GARAGE P1 LEVEL PLAN - AREA A
SCALE: 1/8"=1'-0"

- LEGEND:**
- | | | | |
|----------|--------------------------------|------------------------------|--|
| [FCP] | FIRE ALARM CONTROL PANEL | [Speaker] | WALL MOUNTED SPEAKER, M.H. 80" AFF |
| [FPR] | FIRE PUMP RUN | [Speaker with X] | WALL MOUNTED SPEAKER/ STROBE, M.H. 80" AFF |
| [FPF] | FIRE PUMP FAULT | [Ceiling Speaker] | CEILING MOUNTED SPEAKER |
| [FPO] | FIRE PUMP OFF | [Ceiling Speaker with X] | CEILING MOUNTED STORBE, M.H. 80" AFF |
| [FPRAPS] | FIRE PUMP RUN ALT POWER SOURCE | [Ceiling Speaker and Strobe] | CEILING MOUNTED SPEAKER AND STROBE |
| [IAM] | FIRE ALARM INTERFACE MODULES | [Ceiling Strobe] | CEILING MOUNTED STROBE |
| [GENR] | GENERATOR RUN | [Smoke Detector] | SMOKE DETECTOR |
| [GENF] | GENERATOR FAULT | [Duct Smoke Detector] | DUCT SMOKE DETETOR |
| [TRN] | TURNSTILES | [Heat Detector] | HEAT DETECTOR |
| [PRI] | PRIMARY RECALL | [Valve Tamper Switch] | VALVE TAMPER SWITCH |
| [ALT] | ALTERNATIVE RECALL | [Flow Switch] | FLOW SWITCH |
| [HAT] | FIREMANS HAT | [Alarm Pressure Switch] | ALARM PRESSURE SWITCH |
| [REL] | RELAY MODULE | [High / Low Pressure Switch] | HIGH / LOW PRESSURE SWITCH |
| [ST] | SHUNT TRIP | [Field Photograph] | FIELD PHOTOGRAPH |
| [P] | MANUAL PULL STATION | | |

CLIENT INFORMATION



**SUPERIOR COURT OF THE
DISTRICT OF COLUMBIA**

PROJECT TITLE

**FIRE ALARM RISER & FLOOR PLANS
AS-BUILTS**

PROJECT LOCATION

SOUTH-WEST PARKING GARAGE

SEAL & SIGNATURE

PROFESSIONAL CERTIFICATION:
I HEREBY CERTIFY THAT THESE DOCUMENTS WERE
PREPARED OR APPROVED BY ME, AND THAT I AM A DULY
LICENSED PROFESSIONAL ENGINEER UNDER THE LAWS OF
THE STATE OF MARYLAND, LICENSE NO. _____
EXPIRATION DATE: _____



ASTUTE ENGINEERING, PLLC.
1945 OLD GALLOW'S ROAD, STE 201, VIENNA, VA 22182
PH: (202) 400-2004 | WWW.ASTUTENG.COM

FOR REVIEW ONLY

REVISIONS		
NO.	DESCRIPTION	DATE

TITLE
**GARAGE P1 LEVEL -
AREA A FIRE ALARM
SYSTEM AS-BUILT**

DRAWING NO.
FA101A

SCALE: 1/8"=1'-0"

DATE: 12/04/2023

DES: KS

DRAWN: NS

CHECKED: HU

FOR CONTINUATION, SEE DRAWING FA-101A

1 GARAGE P1 LEVEL PLAN - AREA B
SCALE: 1/8"=1'-0"

CLIENT INFORMATION



SUPERIOR COURT OF THE
DISTRICT OF COLUMBIA

PROJECT TITLE


FIRE ALARM RISER & FLOOR PLANS
AS-BUILTS

PROJECT LOCATION

SOUTH-WEST PARKING GARAGE

SEAL & SIGNATURE

PROFESSIONAL CERTIFICATION.
I HEREBY CERTIFY THAT THESE DOCUMENTS WERE
PREPARED OR APPROVED BY ME, AND THAT I AM A DULY
LICENSED PROFESSIONAL ENGINEER UNDER THE LAWS OF
THE STATE OF MARYLAND, LICENSE NO. _____
EXPIRATION DATE: _____

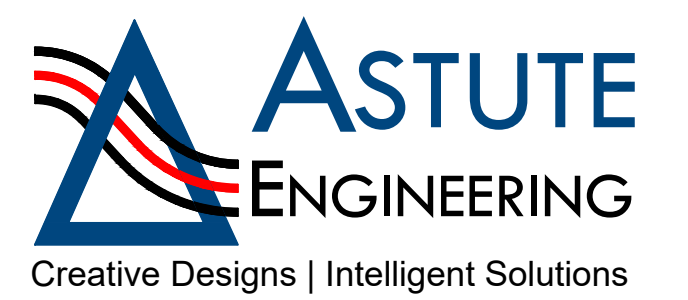

ASTUTE ENGINEERING, PLLC.
45 OLD GALLOWES ROAD, STE 201, VIENNA, VA 22182
PH: (202) 400-2004 | WWW.ASTUTENG.COM

FOR REVIEW ONLY

[illegible]

TITLE
GARAGE P1 LEVEL -
AREA B FIRE ALARM
SYSTEM AS-BUILT

DRAWING NO.
FA101B


SCALE: 1/8"=1'-0"


DATE: 12/04/2023

DES: KS

	DRAWN: NS
--	-----------

CHECKED: HU

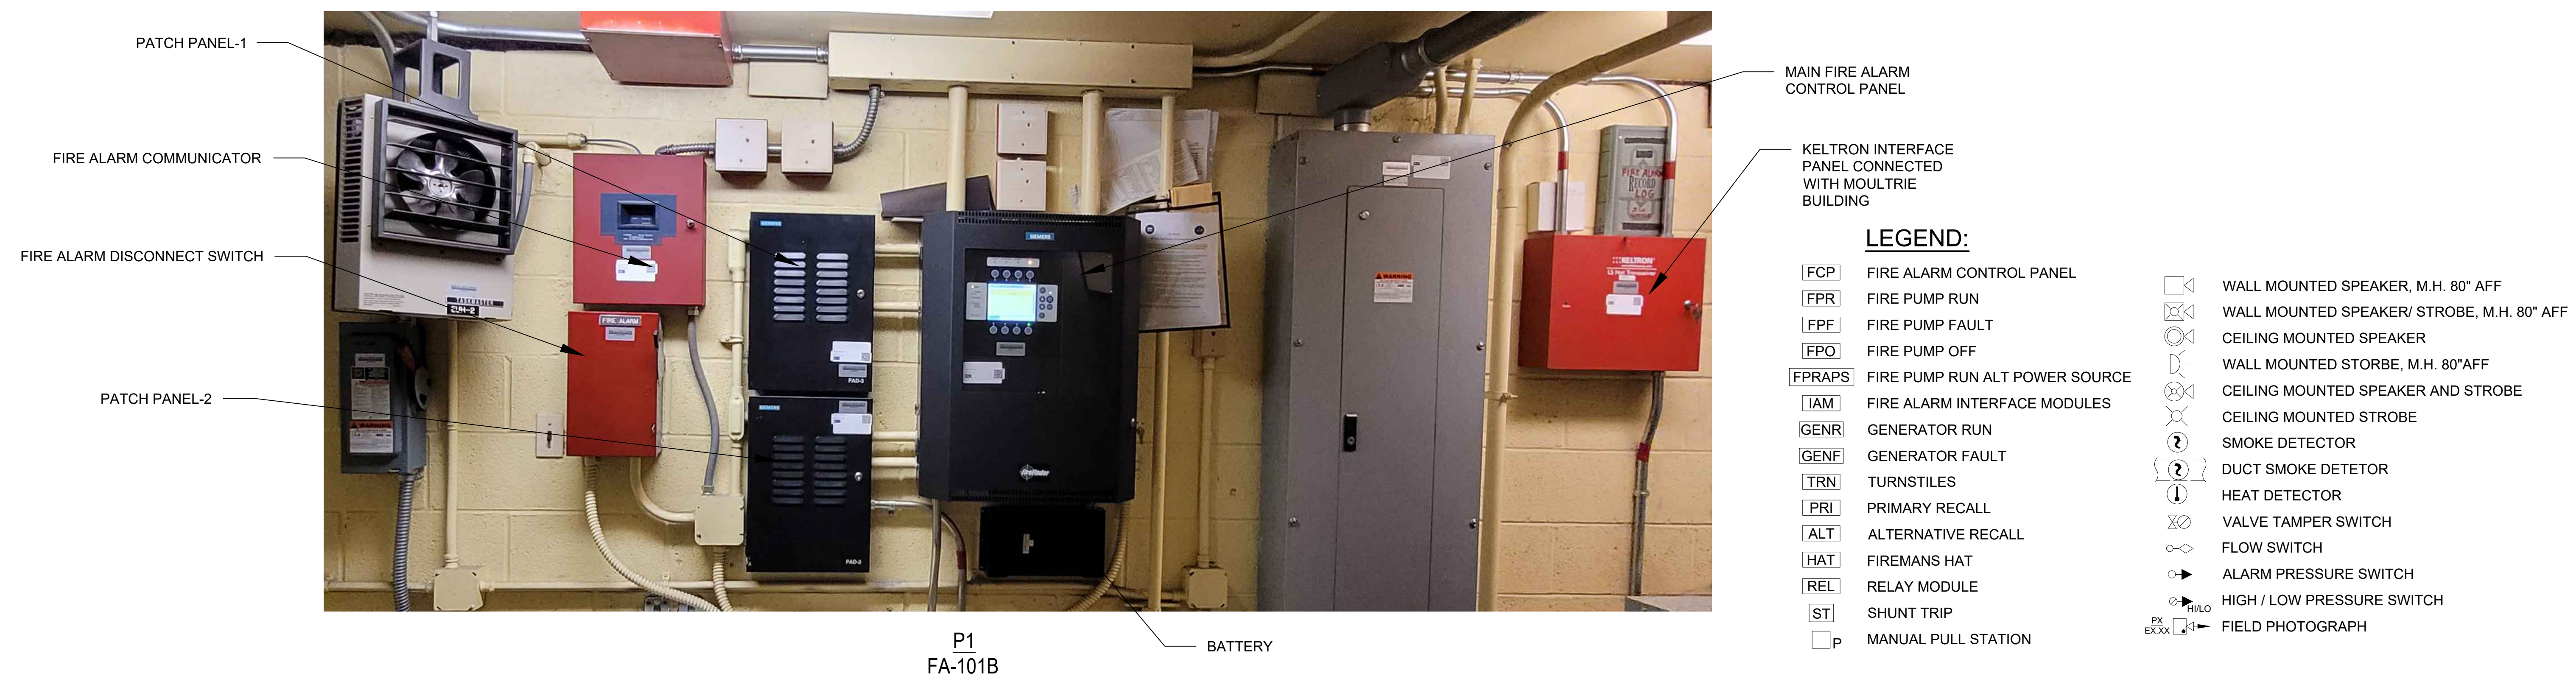

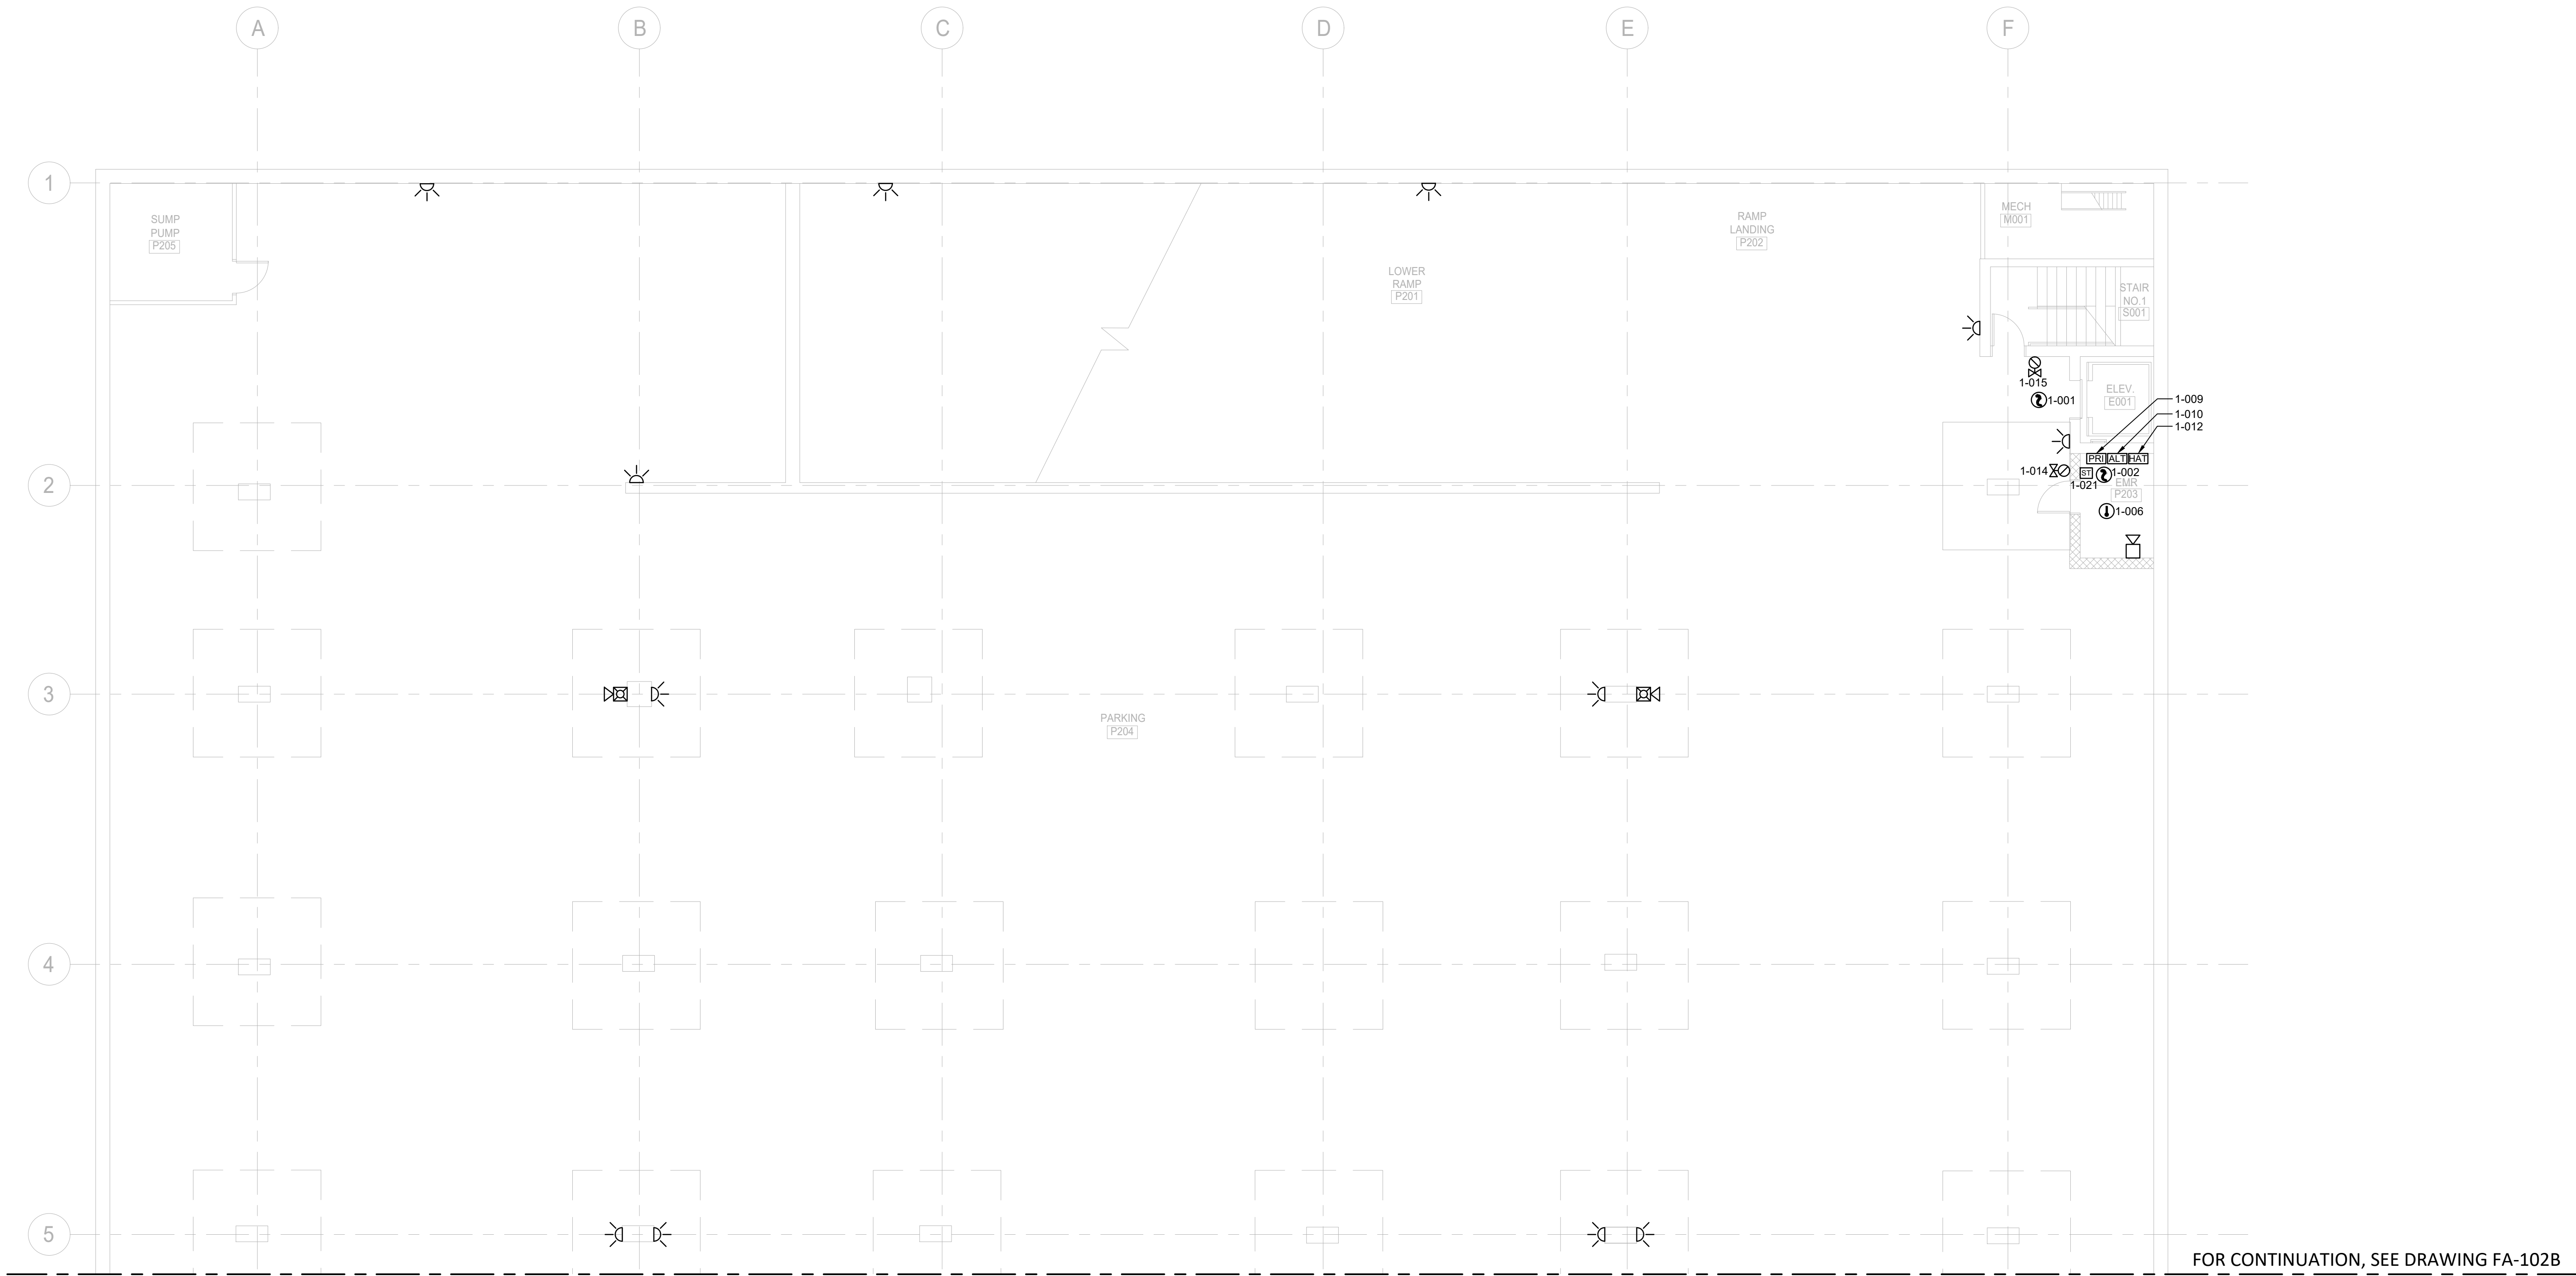

1 GARAGE P2 LEVEL PLAN - AREA A
SCALE: 1/8"=1'-0"

- LEGEND:**
- | | | | |
|----------|--------------------------------|----------|--|
| [FCP] | FIRE ALARM CONTROL PANEL | [WMS] | WALL MOUNTED SPEAKER, M.H. 80" AFF |
| [FPR] | FIRE PUMP RUN | [WMS/ST] | WALL MOUNTED SPEAKER/ STROBE, M.H. 80" AFF |
| [FPF] | FIRE PUMP FAULT | [CMS] | CEILING MOUNTED SPEAKER |
| [FPO] | FIRE PUMP OFF | [WMS/ST] | WALL MOUNTED STORBE, M.H. 80" AFF |
| [FPRAPS] | FIRE PUMP RUN ALT POWER SOURCE | [CMS/ST] | CEILING MOUNTED SPEAKER AND STROBE |
| [IAM] | FIRE ALARM INTERFACE MODULES | [CMS/ST] | CEILING MOUNTED STROBE |
| [GENR] | GENERATOR RUN | [SD] | SMOKE DETECTOR |
| [GENF] | GENERATOR FAULT | [DSM] | DUCT SMOKE DETECTOR |
| [TRN] | TURNSTILES | [HD] | HEAT DETECTOR |
| [PRI] | PRIMARY RECALL | [VTS] | VALVE TAMPER SWITCH |
| [ALT] | ALTERNATIVE RECALL | [FS] | FLOW SWITCH |
| [HAT] | FIREMANS HAT | [APS] | ALARM PRESSURE SWITCH |
| [REL] | RELAY MODULE | [H/LO] | HIGH / LOW PRESSURE SWITCH |
| [ST] | SHUNT TRIP | [FP] | FIELD PHOTOGRAPH |
| [P] | MANUAL PULL STATION | | |

CLIENT INFORMATION



**SUPERIOR COURT OF THE
DISTRICT OF COLUMBIA**

PROJECT TITLE

**FIRE ALARM RISER & FLOOR PLANS
AS-BUILTS**

PROJECT LOCATION

SOUTH-WEST PARKING GARAGE

SEAL & SIGNATURE

PROFESSIONAL CERTIFICATION:
I HEREBY CERTIFY THAT THESE DOCUMENTS WERE
PREPARED OR APPROVED BY ME, AND THAT I AM A DULY
LICENSED PROFESSIONAL ENGINEER UNDER THE LAWS OF
THE STATE OF MARYLAND, LICENSE NO. _____
EXPIRATION DATE: _____



ASTUTE ENGINEERING, PLLC.

1945 OLD GALLOW'S ROAD, STE 201, VIENNA, VA 22182
PH: (202) 400-2004 | WWW.ASTUTENG.COM

FOR REVIEW ONLY

REVISIONS		
NO.	DESCRIPTION	DATE

TITLE

**GARAGE P2 LEVEL -
AREA A FIRE ALARM
SYSTEM AS-BUILT**

DRAWING NO.

FA102A


SCALE: 1/8"=1'-0"

DATE: 12/04/2023

DES: KS

DRAWN: NS

CHECKED: HU

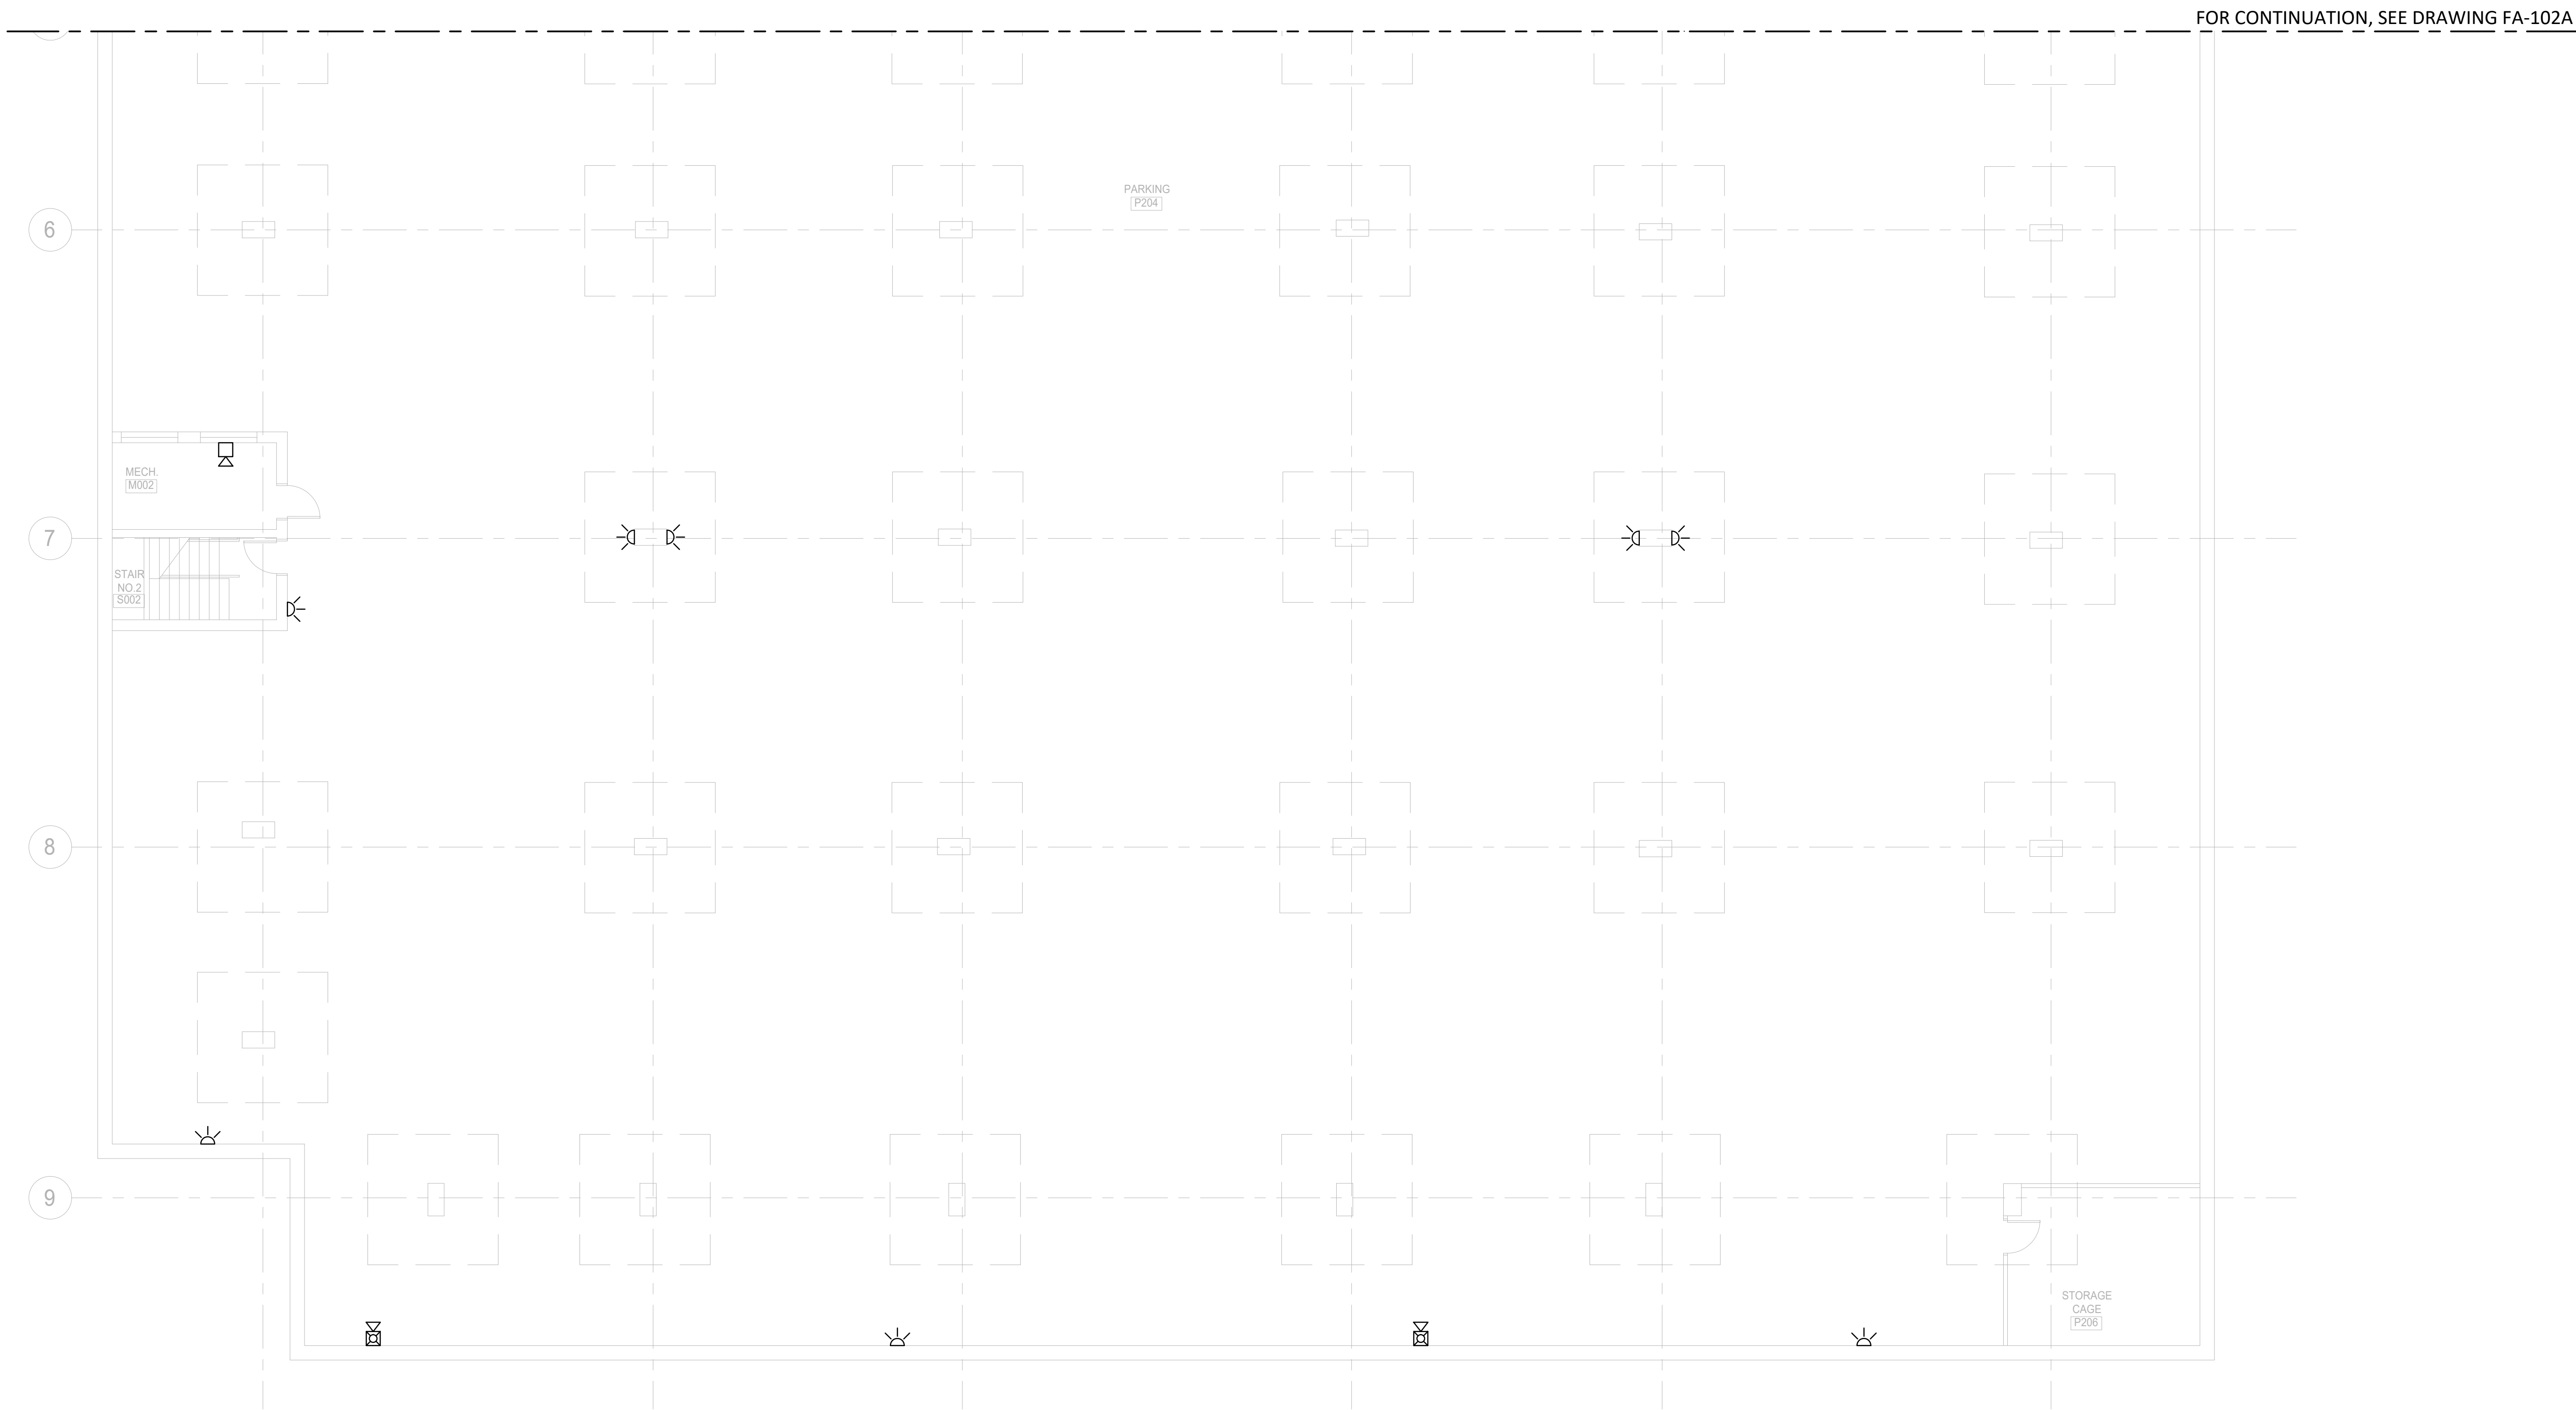

1 GARAGE P2 LEVEL PLAN - AREA B
SCALE: 1/8"=1'-0"

- LEGEND:**
- | | | | |
|----------|--------------------------------|--|--|
| [FCP] | FIRE ALARM CONTROL PANEL | | WALL MOUNTED SPEAKER, M.H. 80" AFF |
| [FPR] | FIRE PUMP RUN | | WALL MOUNTED SPEAKER/ STROBE, M.H. 80" AFF |
| [FPF] | FIRE PUMP FAULT | | CEILING MOUNTED SPEAKER |
| [FPO] | FIRE PUMP OFF | | WALL MOUNTED STORBE, M.H. 80" AFF |
| [FPRAPS] | FIRE PUMP RUN ALT POWER SOURCE | | CEILING MOUNTED SPEAKER AND STROBE |
| [IAM] | FIRE ALARM INTERFACE MODULES | | CEILING MOUNTED STROBE |
| [GENR] | GENERATOR RUN | | SMOKE DETECTOR |
| [GENF] | GENERATOR FAULT | | DUCT SMOKE DETETOR |
| [TRN] | TURNSTILES | | HEAT DETECTOR |
| [PRI] | PRIMARY RECALL | | VALVE TAMPER SWITCH |
| [ALT] | ALTERNATIVE RECALL | | FLOW SWITCH |
| [HAT] | FIREMANS HAT | | ALARM PRESSURE SWITCH |
| [REL] | RELAY MODULE | | HIGH / LOW PRESSURE SWITCH |
| [ST] | SHUNT TRIP | | FIELD PHOTOGRAPH |
| [P] | MANUAL PULL STATION | | |

CLIENT INFORMATION



SUPERIOR COURT OF THE
DISTRICT OF COLUMBIA

PROJECT TITLE

FIRE ALARM RISER & FLOOR PLANS
AS-BUILTS

PROJECT LOCATION

SOUTH-WEST PARKING GARAGE

SEAL & SIGNATURE

PROFESSIONAL CERTIFICATION:
I HEREBY CERTIFY THAT THESE DOCUMENTS WERE
PREPARED OR APPROVED BY ME, AND THAT I AM A DULY
LICENSED PROFESSIONAL ENGINEER UNDER THE LAWS OF
THE STATE OF MARYLAND, LICENSE NO. _____
EXPIRATION DATE: _____



ASTUTE ENGINEERING, PLLC.
1945 OLD GALLOW'S ROAD, STE 201, VIENNA, VA 22182
PH: (202) 400-2004 | WWW.ASTUTENG.COM

FOR REVIEW ONLY

REVISIONS		
NO.	DESCRIPTION	DATE

TITLE
GARAGE P2 LEVEL -
AREA B FIRE ALARM
SYSTEM AS-BUILT

DRAWING NO.
FA102B

SCALE: 1/8"=1'-0"

DATE: 12/04/2023

DES: KS

DRAWN: NS

CHECKED: HU